



Retaining Walls

10	77.24	21	78.55
11	77.65	22	78.73
12	77.52	23	78.74
13	77.55	24	78.49
14	77.80	25	78.55
15	77.69	26	78.44
16	77.79	27	78.73
17	78.72	28	77.79
18	78.40	29	77.73
19	78.48	30	77.86
21	78.74	31	77.63

# CERTIFICATION OF AS-BUILT GRADES (LOT GRADING CERTIFICATE)

SUBJECT TO THE ACCEPTANCE  
OF THE LOCAL APPROVING AUTHORITY

Surface Condition : Topsoil

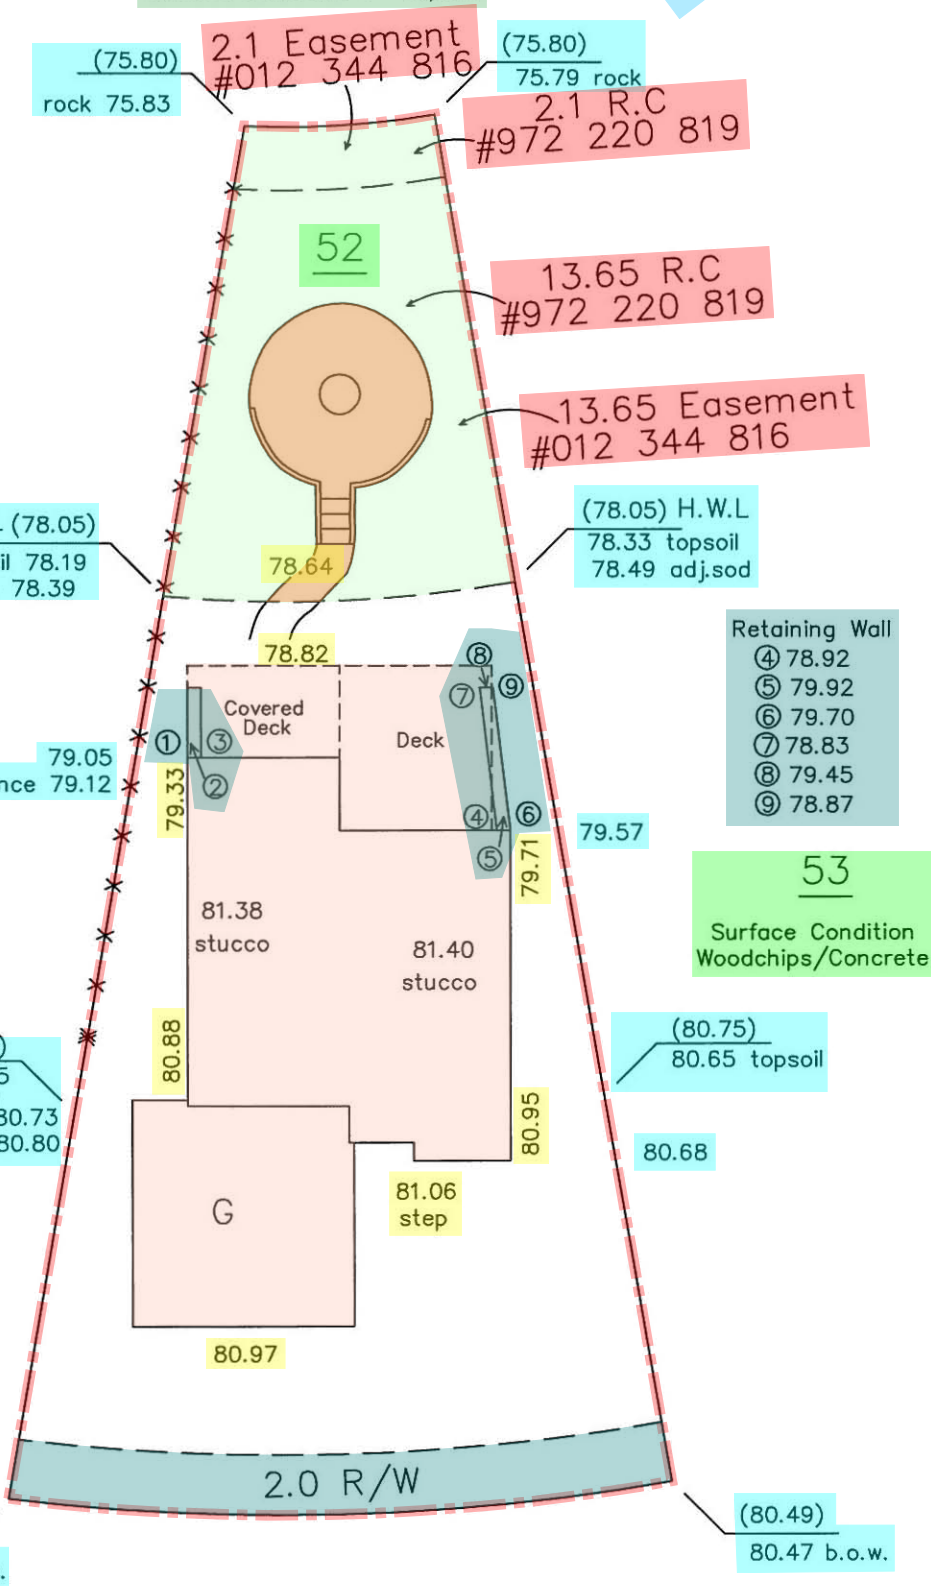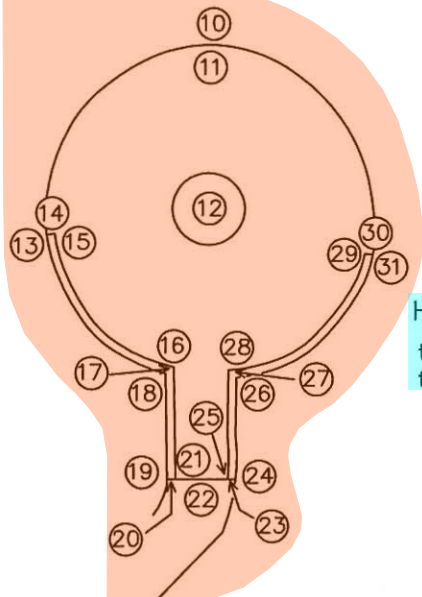

Retaining Wall

1	79.12
2	79.74
3	78.90

51  
Surface Condition  
Woodchips

53  
Surface Condition  
Woodchips/Concrete

Contact:  
b.o.w. - denotes grade @ Back Of Walk  
X X X - Fence

This document does not release the Builder\Owner from any additional work required by the Local Approving Authority

Elevations shown are referred to geodetic datum.

NOTES :  
ALL DISTANCES SHOWN ARE IN METRES AND DECIMALS THEREOF.  
DESIGN GRADES ARE SHOWN THUS (999.99)  
\* - Elevation Out Of Tolerance And/Or Checked And Confirmed.  
Pals Surveys accepts no financial responsibility for any costs which may be incurred as a result of this document not being accepted by the Local Approving Authority.

Front INFORMATION ONLY

THIS IS TO CERTIFY THAT  
LOT GRADES SHOWN ON THE ABOVE PLAN ARE  
AS-BUILT ELEVATIONS RECORDED ON June 17 & Oct. 9, 2009



Brian Doyle, ALBERTA LAND SURVEYOR

BUILDER\OWNER

LOT	BLOCK	PLAN
SUBDIVISION	Lake District	
IN	Edmonton	ALBERTA

SCALE: 1 : 250 DATE DRAWN: Oct. 13, 2009 C

