



**CERTIFICATION OF AS-BUILT GRADES  
(LOT GRADING CERTIFICATE)**

**SUBJECT TO THE ACCEPTANCE  
OF THE LOCAL APPROVING AUTHORITY**

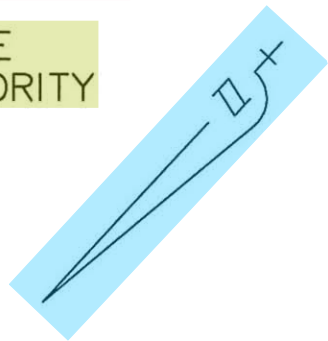

Surface Condition : Clay

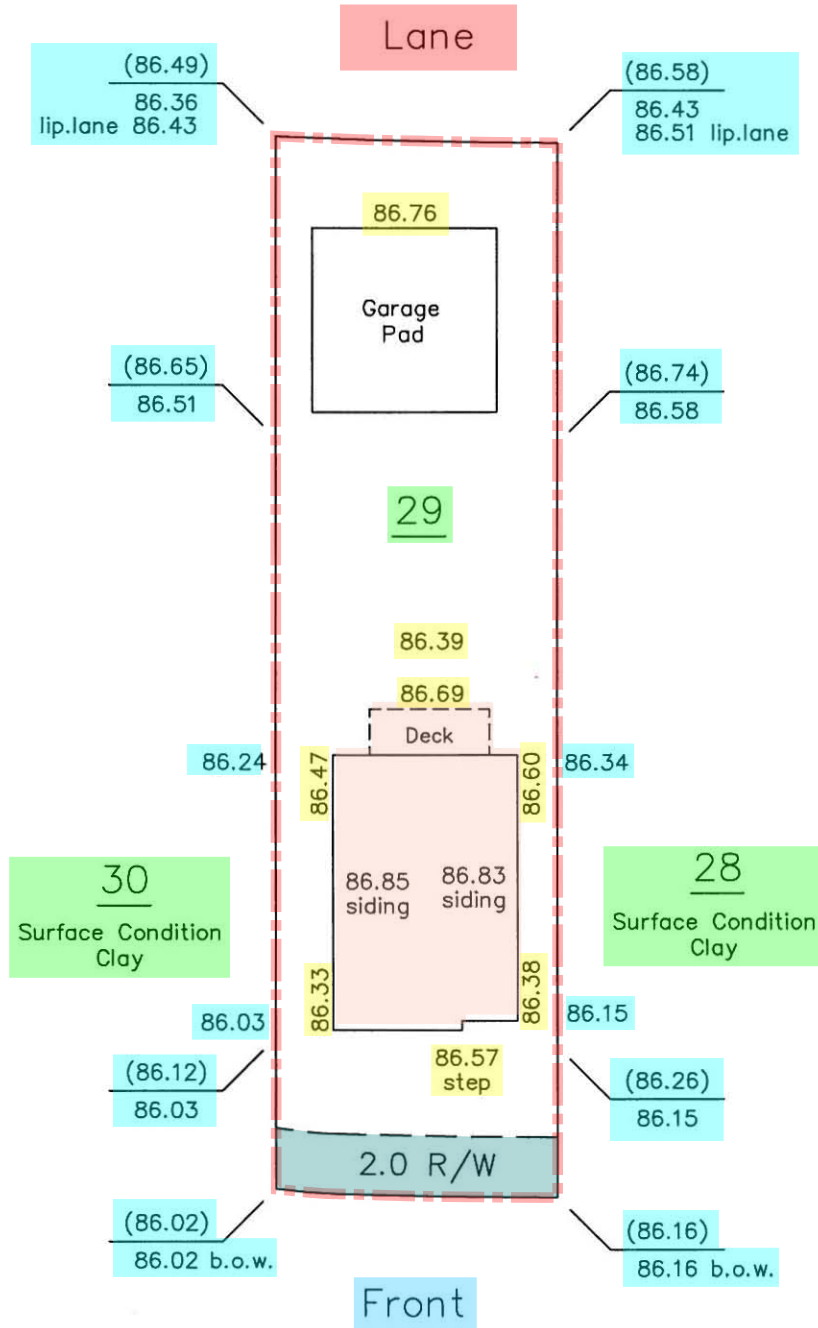

Contact:

(Civic Address)

b.o.w. — denotes grade @ Back Of Walk

This document does not release the Builder\Owner from any additional work required by the Local Approving Authority

Elevations shown are referred to geodetic datum.

**NOTES :**

ALL DISTANCES SHOWN ARE IN METRES AND DECIMALS THEREOF.

DESIGN GRADES ARE SHOWN THUS (999.99)

\* — Elevation Out Of Tolerance And/Or Checked And Confirmed.  
Pals Surveys accepts no financial responsibility for any costs which may be incurred as a result of this document not being accepted by the Local Approving Authority.

**INFORMATION ONLY**

**THIS IS TO CERTIFY THAT  
LOT GRADES SHOWN ON THE ABOVE PLAN ARE  
AS-BUILT ELEVATIONS RECORDED ON Sept. 26/09**



Brian Doyle, ALBERTA LAND SURVEYOR

BUILDER\OWNER

SCALE: 1 : 250      DATE DRAWN: Sept. 28/09    c

LOT                      BLOCK                      PLAN  
SUBDIVISION    Ambleside  
IN    Edmonton                      ALBERTA

**P** Pals Surveys & Associates LTD.